

## **ADDENDUM NO. 1**

To the Plans and Specifications for the

### **GARLOCK ROAD DELAMETER CREEK FISH PASSAGE PROJECT**

**Project No. 1779**

For the Department of Public Works, Cowlitz County, Washington

Bid Opening Date: **April 21, 2025, at 1:30 p.m.** (unchanged)

**THIS ADDENDUM IS HEREBY MADE A PART OF THE CONTRACT DOCUMENTS TO THE SAME EXTENT AS THOUGH IT WAS ORIGINALLY INCLUDED THEREIN.**

#### **SPECIAL PROVISIONS**

##### **1-07.14 Responsibility for Damage**

Delete the third and fourth paragraphs of the Special Provisions for Section 1-07.4 which begins "After the Contractor has completed clearing and grubbing..." and replace with the following:



Comcast has installed temporary communications facilities around the project area and has deactivated the existing underground communications lines that cross over the existing concrete box culvert. The Contractor shall cut and remove these deactivated underground communications as necessary to complete the structure excavation.

After the new culvert is installed and backfilled, Comcast will provide conduit for permanent installation. The Contractor shall install this conduit over the new culvert and along the roadway, which will be paid under the bid item Miscellaneous Construction. Comcast will install their permanent underground communications lines within the conduit and will connect to the existing Comcast facilities near the ends of the project area.

#### **PLANS**

##### **Sheet 3 - Roadway Plan**

Revisions are made to the beam guardrail as shown on the revised sheet 3. Included in these revisions is the increase in the radius of some beam guardrail from 10 feet to 20 feet.

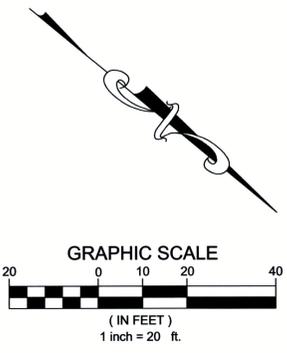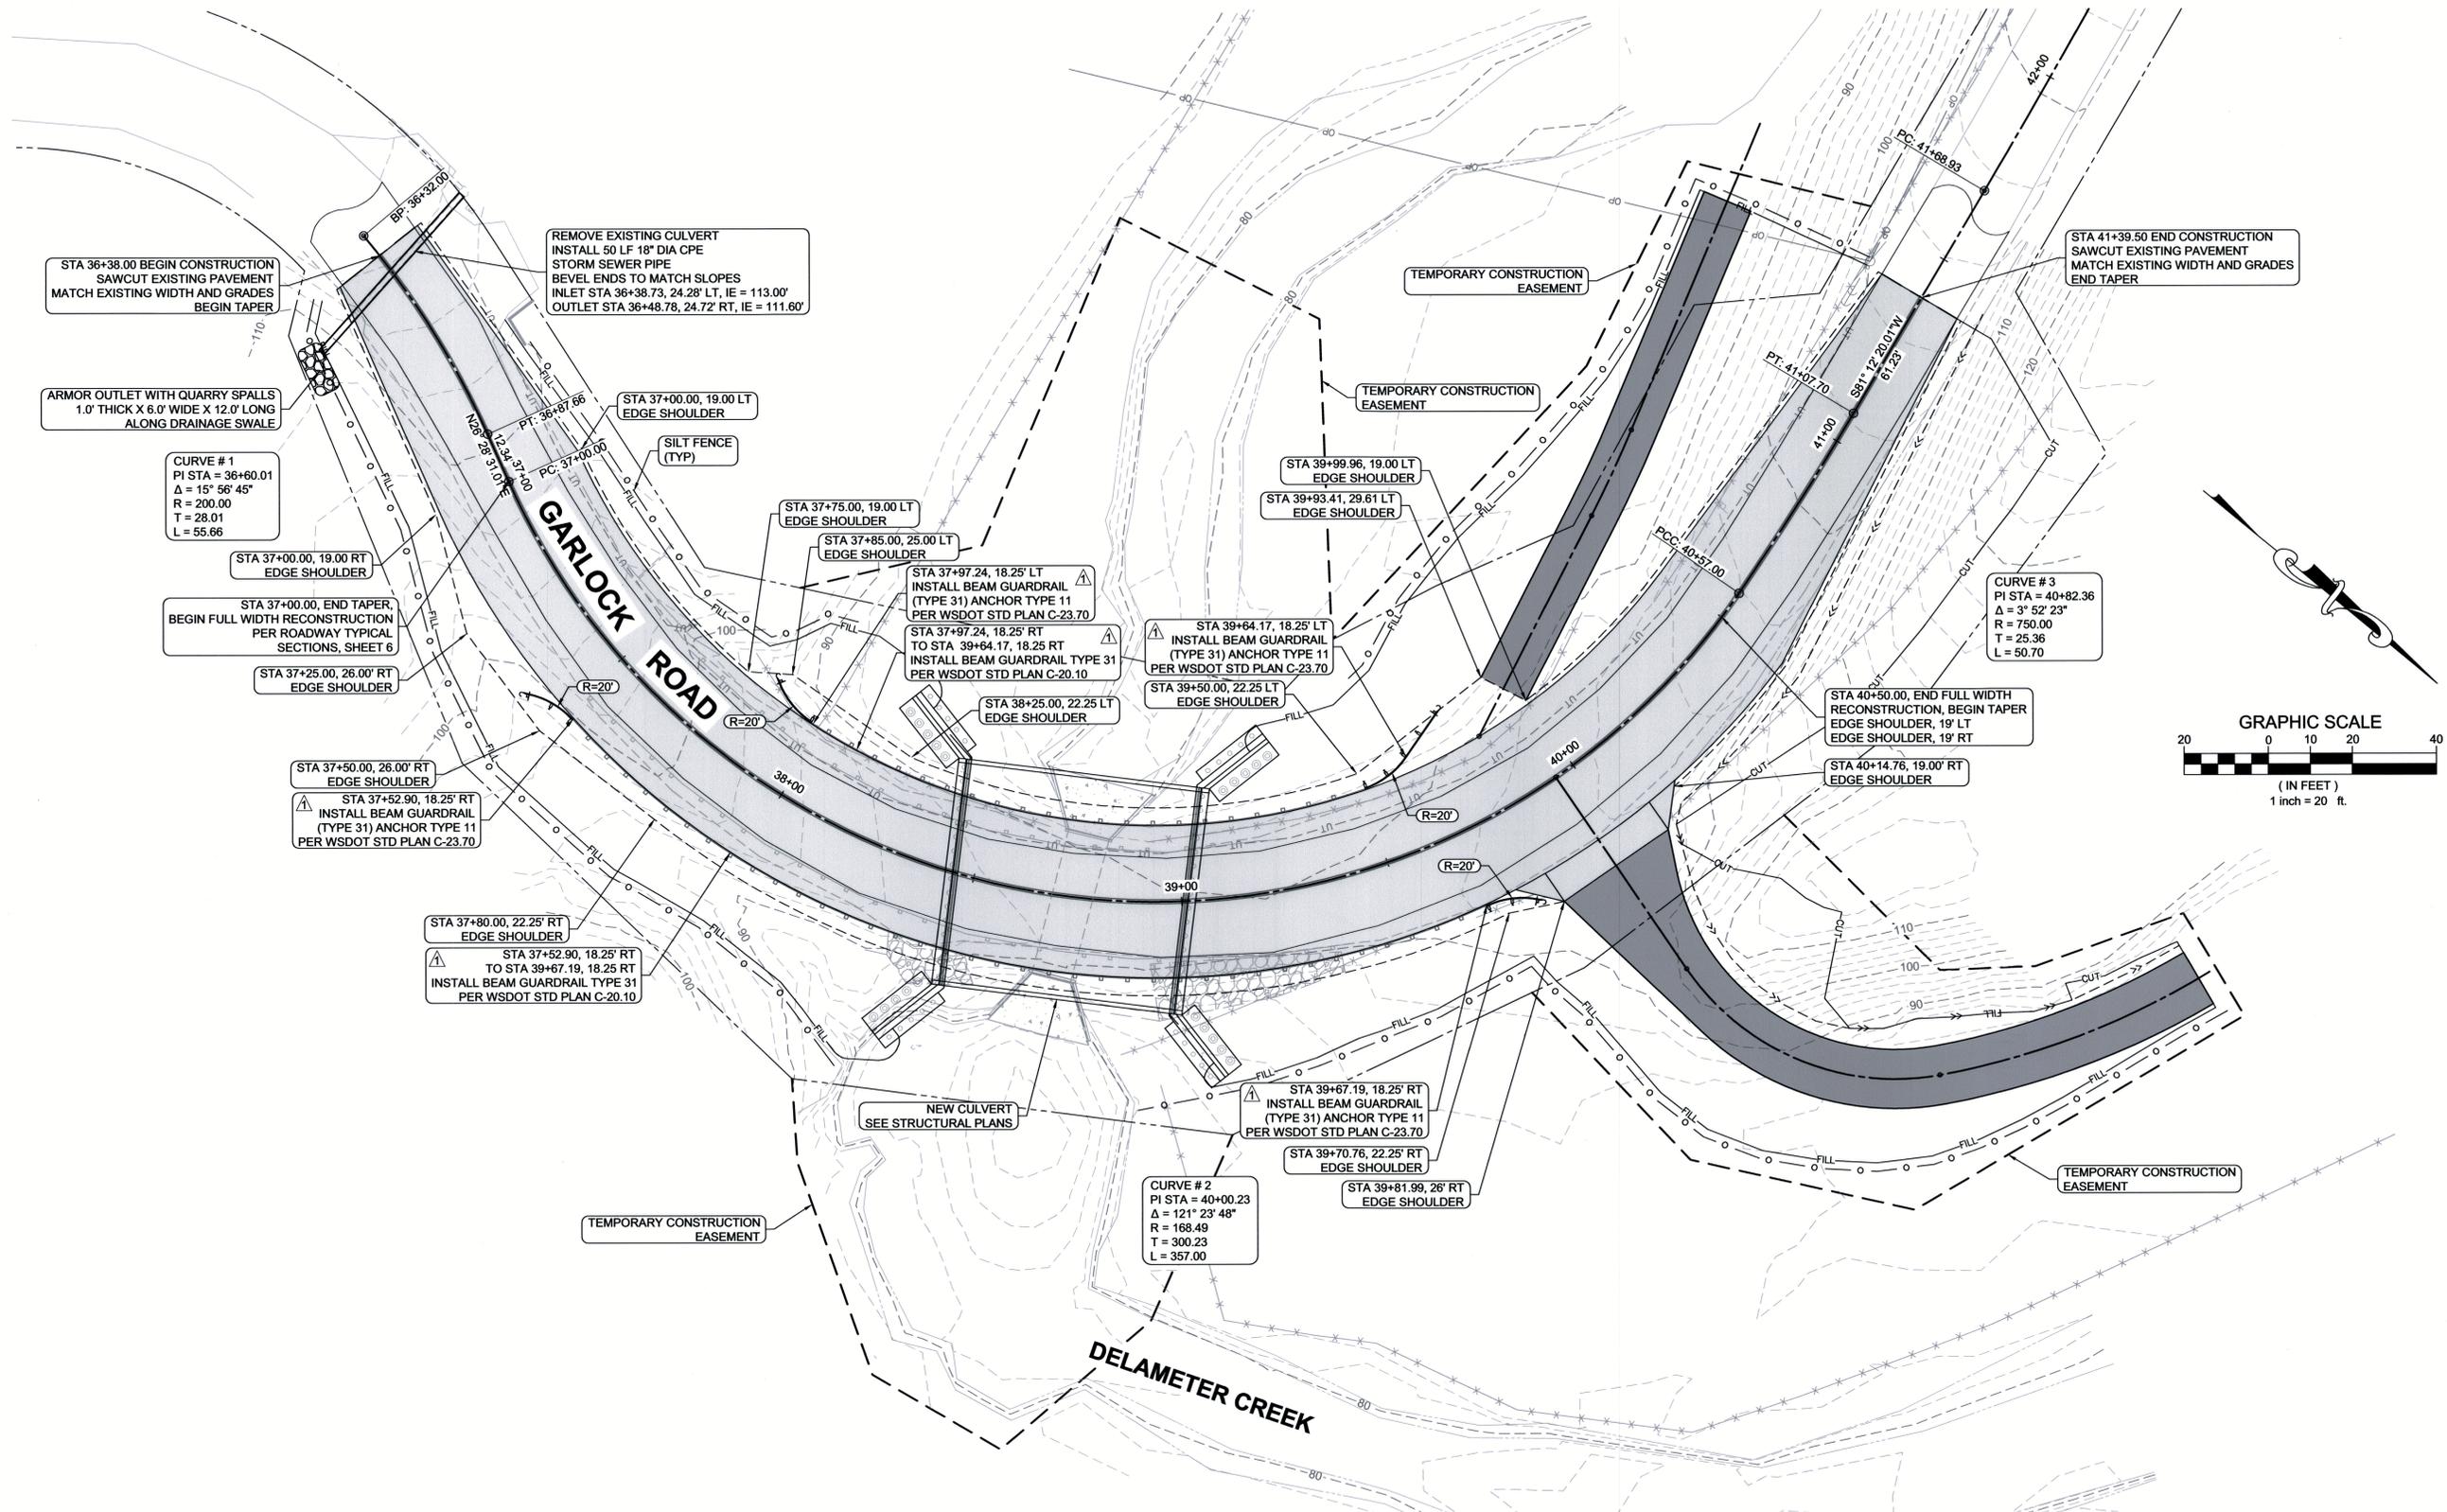

PLAN

4/9/25

▲ GUARDRAIL REVISIONS 4/8/25

R.E.M. PROJECT MANAGER  
 DATE 4/9/2025  
 D.J.B. DRAWN BY  
 DATE 4/9/2025  
 S.E.E. CHECKED BY  
 DATE 4/9/2025

HORIZ. SCALE: 1" = 20'  
 VERT. SCALE:  
 PROJECT ID: 1779  
 ROAD NO.: 23200  
 COMPUTER FILE: 1779 Garlock Design.dwg

**COWLITZ COUNTY WASHINGTON**

DEPARTMENT OF PUBLIC WORKS

1600 13TH AVENUE SOUTH  
 KELSO, WASHINGTON 98626

NOTE: SCALES SHOWN ARE FOR FULL SIZE (24"x36") PLAN SHEETS ONLY. SCALES FOR HALF SIZE PLAN SHEETS ARE APPROXIMATELY ONE HALF SCALE.



Sec. 17 & 18, T 9N, R 2W

**GARLOCK ROAD - DELAMETER CREEK  
 FISH PASSAGE PROJECT  
 ROADWAY PLAN**

SHEET 3 OF 25

**ATTACHMENTS TO THIS ADDENDUM**

- Revised plan sheet 3.

***Acknowledgment of this addendum is required under ADDENDA on Page 10 of the Contract Documents.***

ISSUED THIS 9<sup>TH</sup> DAY OF APRIL, 2025.

  
SUSAN EUGENIS, P.E.  
County Engineer  
Cowlitz County Public Works  
1600 13<sup>th</sup> Avenue South  
Kelso, WA 98626